


DO NOT SCALE FROM DRAWING.
 ALL MARKED DIMENSIONS TO BE CHECKED ON SITE BY CONTRACTOR PRIOR TO CONSTRUCTION.

First Floor General Arrangement
 AS BUILT
 SCALE: 1:20

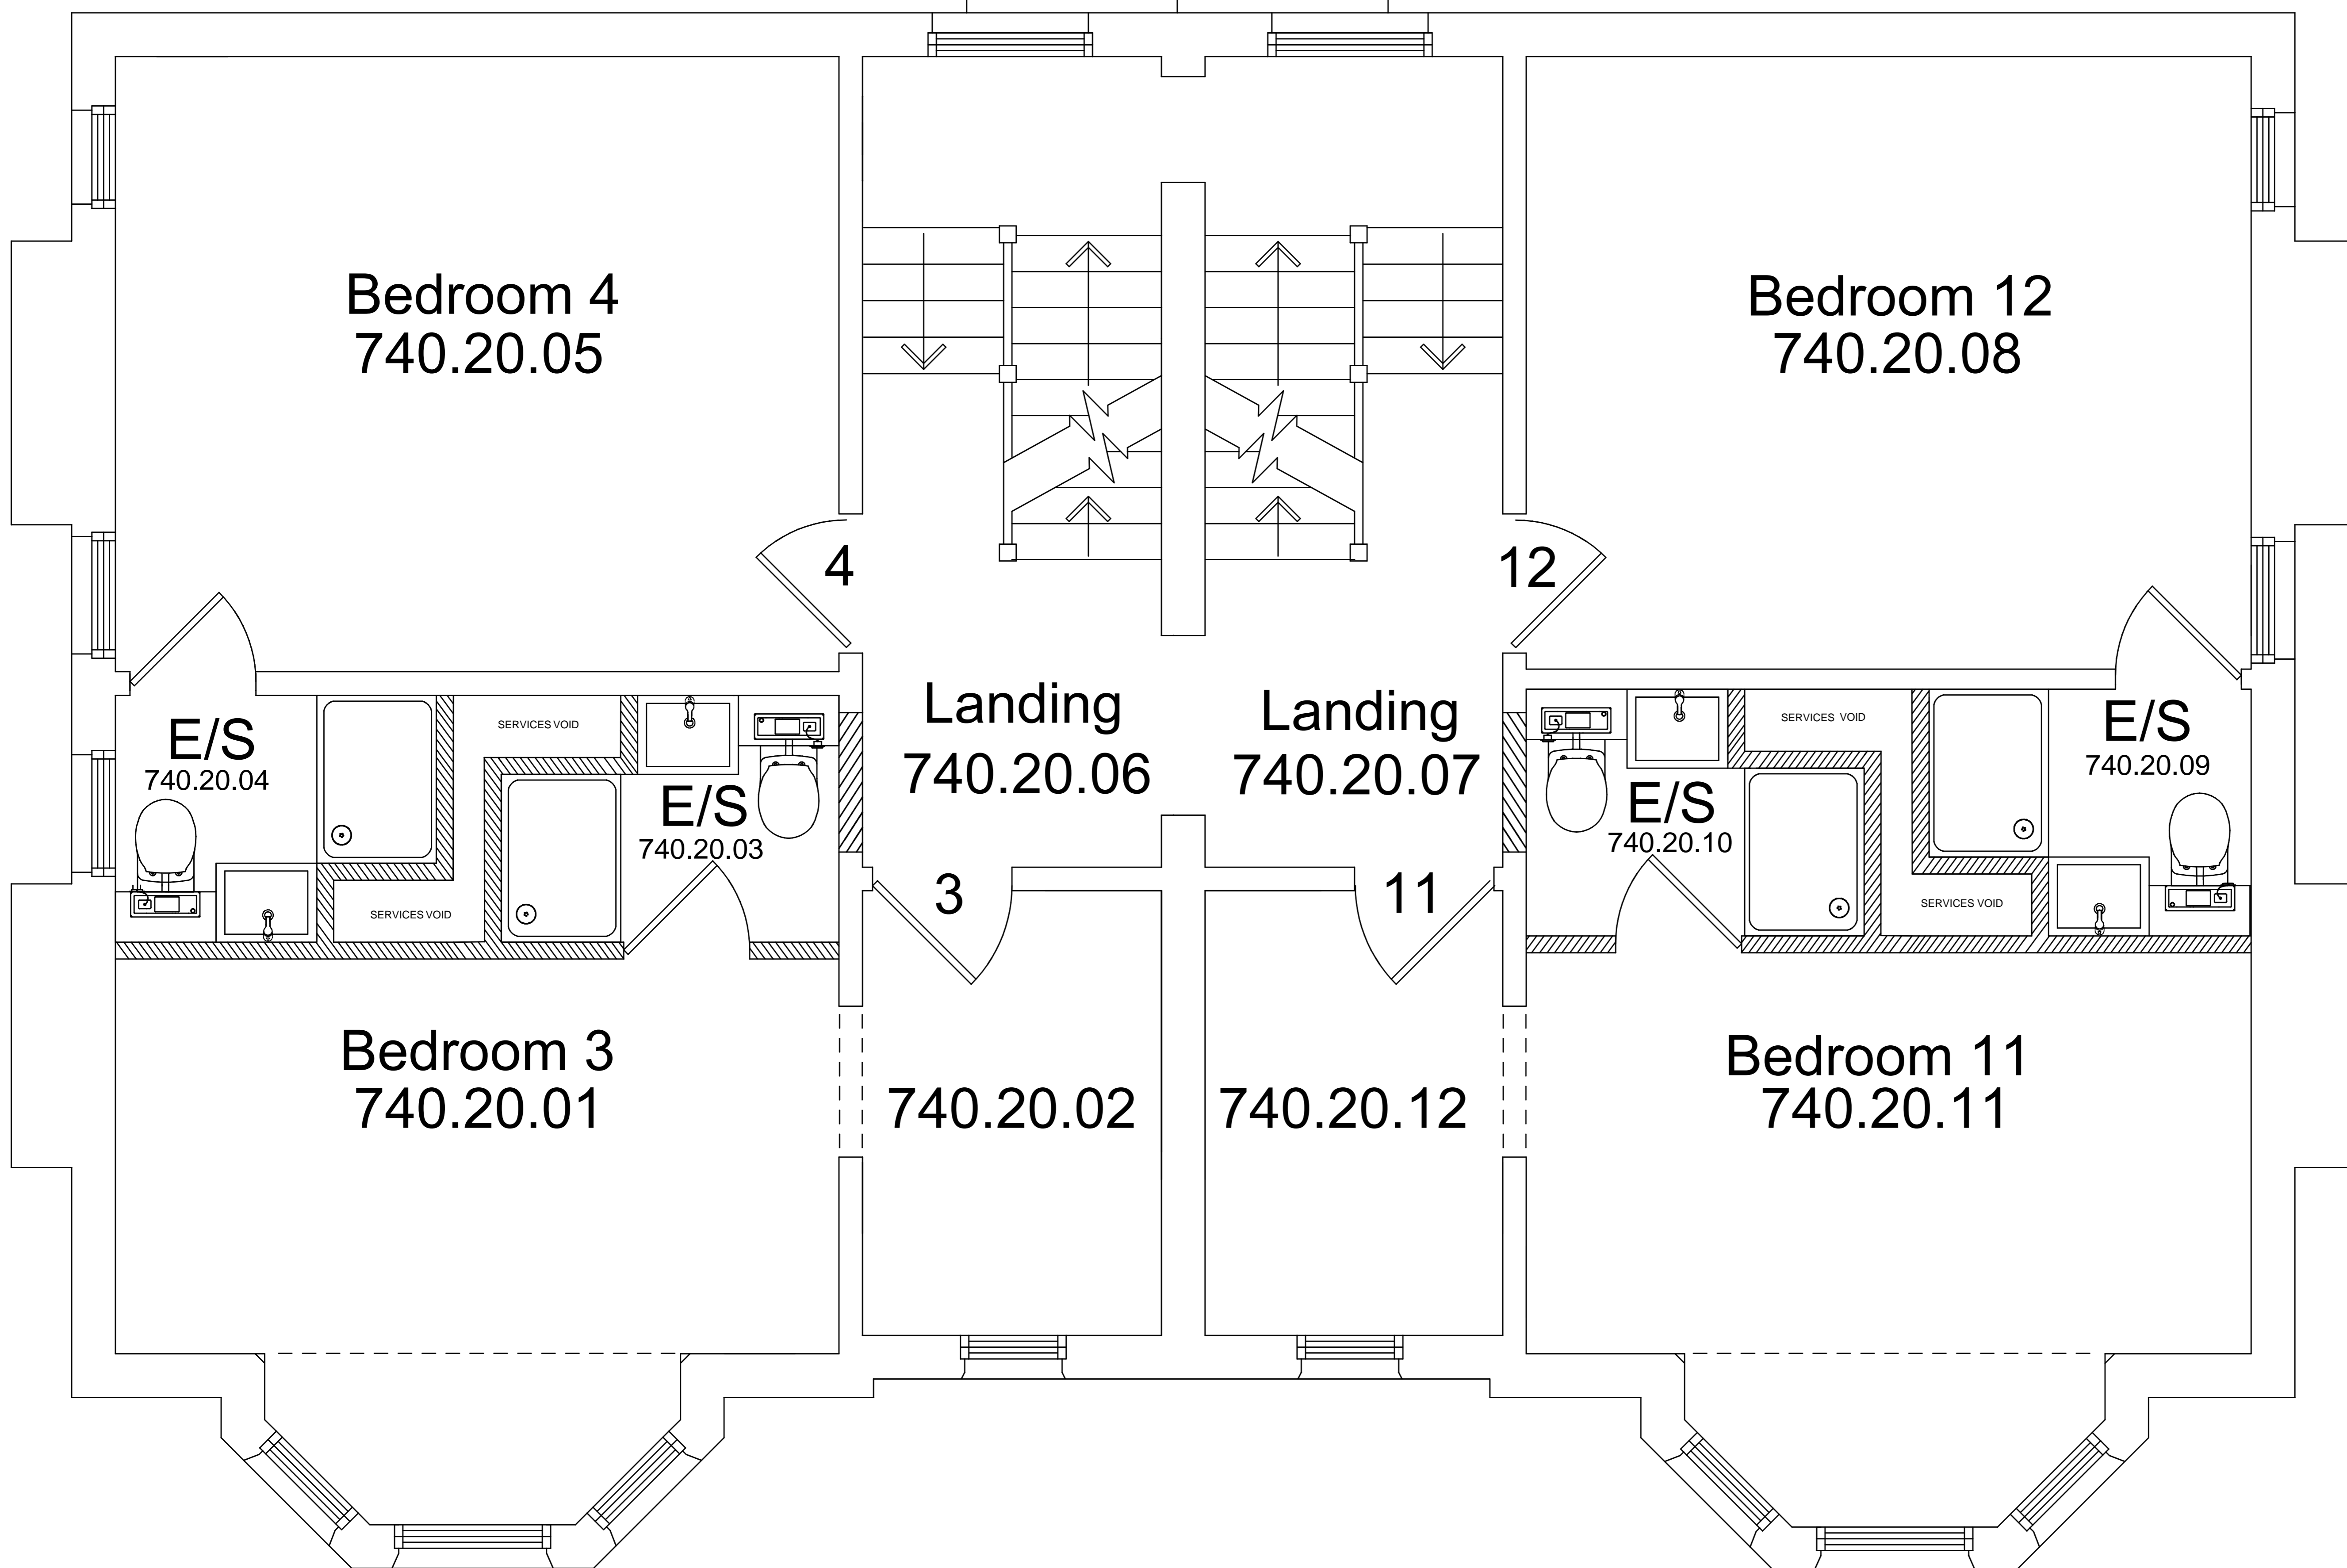

AS BUILT



ESTATES SERVICES			
PROJECT	Refurbishment & Internal Alteration Works Project		
DRAWING	First Floor As Built Layout		
BUILDING	38-40 Woodstock Road (Graduate Accommodation)		
FLOOR	First		
DRAWING NO	740/A03		
SCALE	1:20	SIZE	A1
DRAWN BY	MW	REVISION	
CHECKED BY		DATE	26 Aug 2015
CHECK ALL DIMENSIONS. DO NOT SCALE			
© OXFORD UNIVERSITY ESTATES SERVICES			